
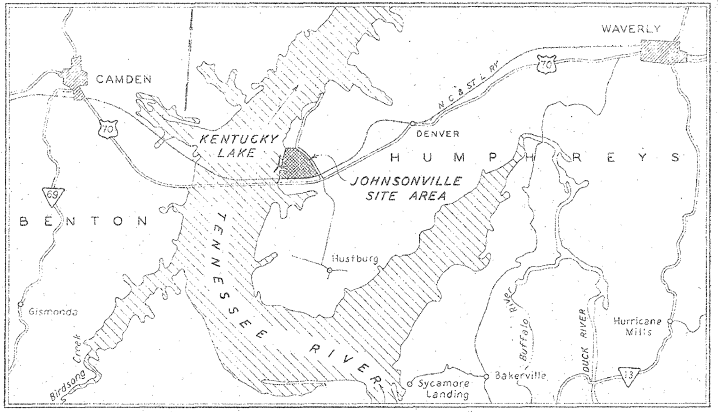


002 NO1

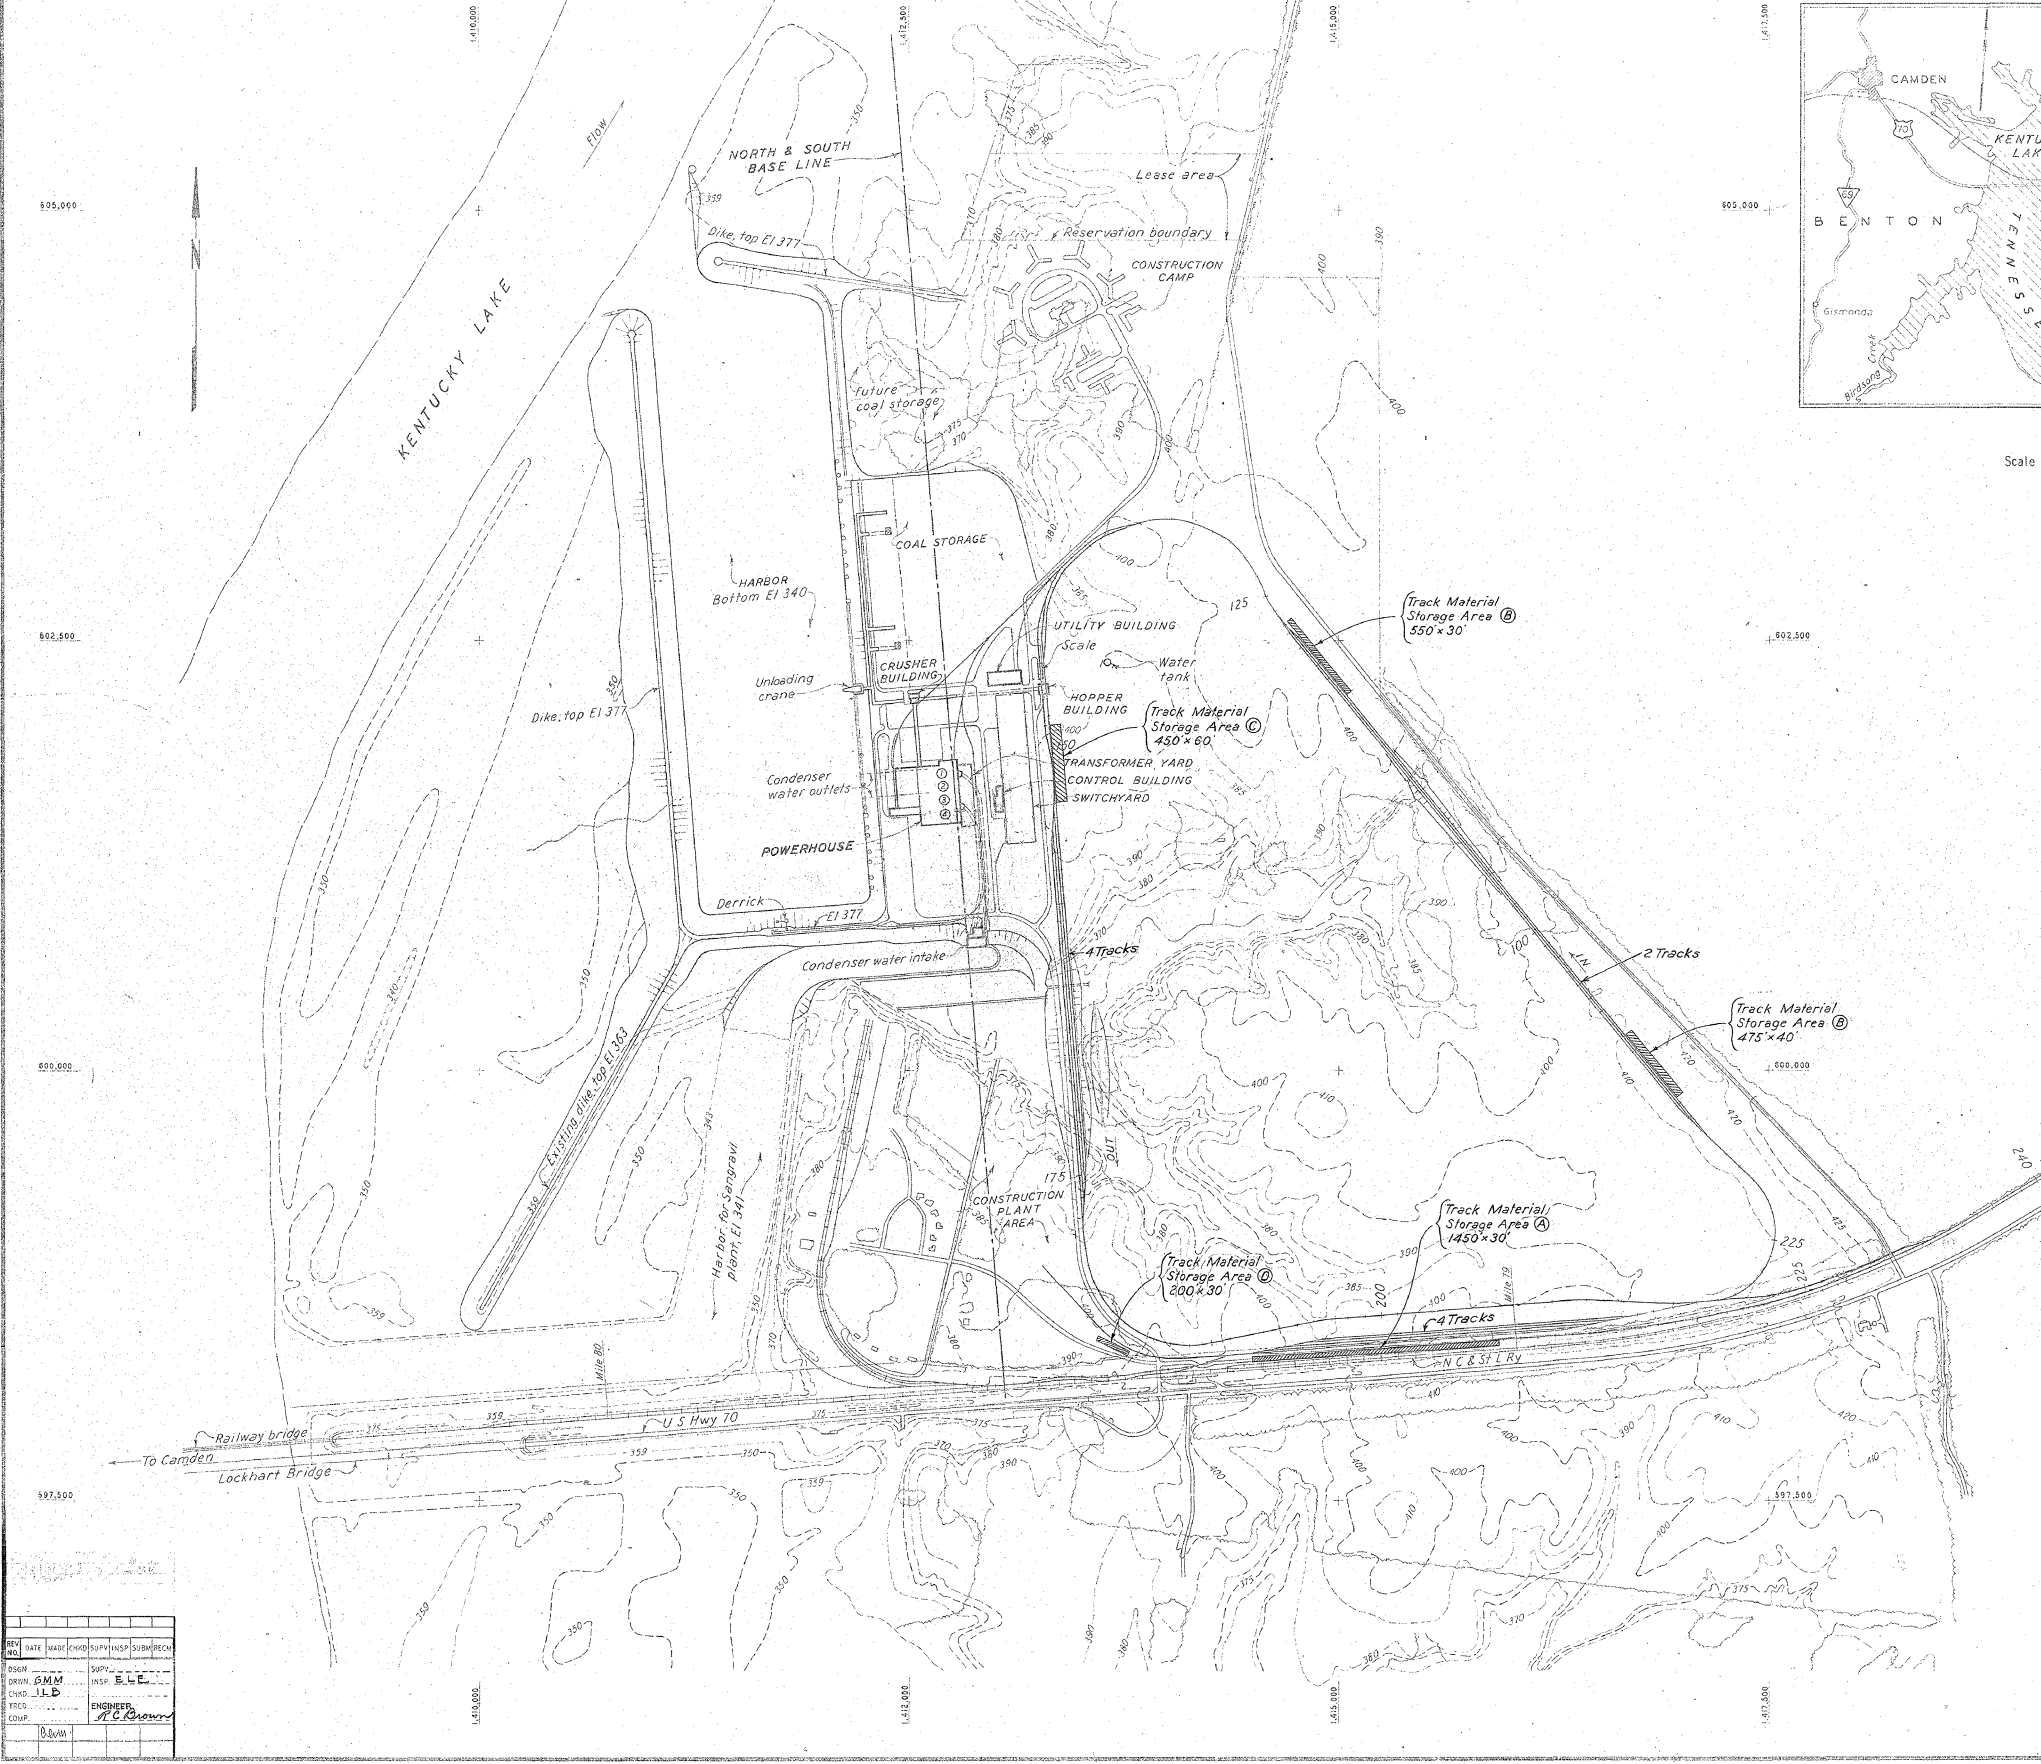

KEY MAP  
Scale 2 0 2 4 Miles

LEGEND  
TRACKS INCLUDED IN CONTRACT

Scale .400 0 400 800 Feet

REV	DATE	BY	CHKD	SUPV	INSP	SUB	RECK

TRACK LAYING AND SURFACING

LOCALITY MAP

JOHNSONVILLE STEAM PLANT  
TENNESSEE VALLEY AUTHORITY  
DIVISION OF DESIGN

SUBMITTED	RECOMMENDED	REVIEWED	APPROVED
<i>Carroll</i>	<i>A. O. Meyer</i>	<i>Frank W. White</i>	<i>R. A. Morrison</i>
KNOXVILLE	6-6-50	30	C 4

ION 700 R0

RECORD DRAWING AS CONSTRUCTED

State of Tenn. Records Section  
Knoxville